

Appeal Period Expires 9/25/12
 Zoning District R2

Town of Essex, Vermont
Application for Zoning Permit
 www.essex.org

Application Date 1/1/12
 Permit Number 2012-150

All construction is to be completed in accordance with the Town of Essex Zoning Regulations and any/all federal or state regulations now in effect. You are required to post this permit in a conspicuous location on the property during the appeal period and it must remain posted throughout the construction period. **You are required to contact the necessary state agencies to obtain state permits @ 879-5676.**

Any interested person may appeal the decision of the Zoning Administrator to the Zoning Board of Adjustment within fifteen (15) days of the permit's date of issuance. Commencing construction within this fifteen (15) day appeal period is prohibited by law.

Signed: [Signature]

Parcel Account Numb. (Map-Parcel-Lot) 2-052-017-001
 (found in Town Assessor's Office)
 Property Address: 136 Jericho Road Essex Vermont
 Owner: Mountaha Handy Trust
 Owner Address: 75 South Winooski Ave
 Owner Phone: (work) 603-344-2684 (home) _____
 (cell) 802-373-9200 (Email) MULAK@MOUNTAHA.COM
 Contractors name: Paul Rebelo - PBR Phone: _____
 Cell: 503-809-0198
 Estimated Construction Dates: Start: 9/17/12 Completion: 9/27/12
 Sq. Feet: 800 Estimated Cost (labor & materials): \$ _____

G

Check box(es) which describe proposed use or construction (circle choice in parenthesis).
 N = New A = Addition R = Remodel

<i>Residential:</i>	N	A	R
Single Family	<input type="checkbox"/>	<input type="checkbox"/>	<input type="checkbox"/>
Two-family (duplex)(other)	<input type="checkbox"/>	<input type="checkbox"/>	<input type="checkbox"/>
Multi-family	<input type="checkbox"/>	<input type="checkbox"/>	<input type="checkbox"/>
Condominium / Townhouse	<input type="checkbox"/>	<input type="checkbox"/>	<input type="checkbox"/>
Mobile home	<input type="checkbox"/>	<input type="checkbox"/>	<input type="checkbox"/>
<i>Inclusions or Additions:</i>			
Garage (attached) (detached)	<input type="checkbox"/>	<input type="checkbox"/>	<input type="checkbox"/>
Porch (enclosed) (open)	<input type="checkbox"/>	<input type="checkbox"/>	<input type="checkbox"/>
Deck	<input type="checkbox"/>	<input type="checkbox"/>	<input type="checkbox"/>
Pool (in) (above) ground	<input type="checkbox"/>	<input type="checkbox"/>	<input type="checkbox"/>
Shed	<input type="checkbox"/>	<input type="checkbox"/>	<input type="checkbox"/>
Barn (residential) (agriculture)	<input type="checkbox"/>	<input type="checkbox"/>	<input type="checkbox"/>
<i>Non-residential:</i>			
Commercial / Industrial	<input type="checkbox"/>	<input type="checkbox"/>	<input checked="" type="checkbox"/>
Stormwater:			
Stormwater	<input type="checkbox"/>	<input type="checkbox"/>	<input type="checkbox"/>
Erosion Control	<input type="checkbox"/>	<input type="checkbox"/>	<input type="checkbox"/>
<i>Other:</i>			
Change in use	<input type="checkbox"/>	<input type="checkbox"/>	<input type="checkbox"/>
Miscellaneous	<input type="checkbox"/>	<input type="checkbox"/>	<input type="checkbox"/>
Renewal	<input type="checkbox"/>	<input type="checkbox"/>	<input type="checkbox"/>

B Sewage Disposal (Please attach Sewer or Septic Application).
 Public Private Connection Fee \$ _____ Date Paid: 1/1/12
 Proposed New Bedrooms: _____ Existing Bedrooms Existing

C Water (Please attach Water Service Application). Existing
 Public Private Fee \$ _____ Date Paid: 1/1/12

D Driveway (Please attach copy of approved Curbcut / Utility Application).
 Date of approval 1/1/12 Existing

E Stormwater Follow erosion control measures
 Project disturbs an area greater than or equal to 1 acre - Erosion Control Permit Required. Attach completed permit application.
 Project creates new or expands existing impervious surface greater than or equal to 1/2 acre - Erosion Control Permit and Stormwater Management Permit required. Attach completed permit application.

F Diagram - Show a sketch of project on reverse of this application with property lines, building, and setbacks or attach separate sheet. (Instruction sheet available upon request.)
See attachment
plus see site plan approval
PC: 2012-3



G Signature of Tenant and Signature of Owner [Signature]

Office Use Only

Fees	Type	Amount	Date Pd
Permit		\$ <u>100.00</u>	<u>9/14/12</u>
Recreation		\$ _____	<u>1/1/12</u>
Recording		\$ <u>20.00</u>	<u>9/14/12</u>
Certificate of Occ		\$ <u>15.00</u>	<u>9/14/12</u>
Other		\$ _____	<u>1/1/12</u>

Building Permit
 Approved Rejected Date 9/10/12
 Issued to: Mountaha Handy Trust
 Zoning Administrator: Sharon Kelly
 Notes: All construction shall file after permit to Planning Commission Approval
 C.O. Required Yes No

THIS PERMIT VALID FOR TWELVE (12) MONTHS FROM DATE OF ISSUE

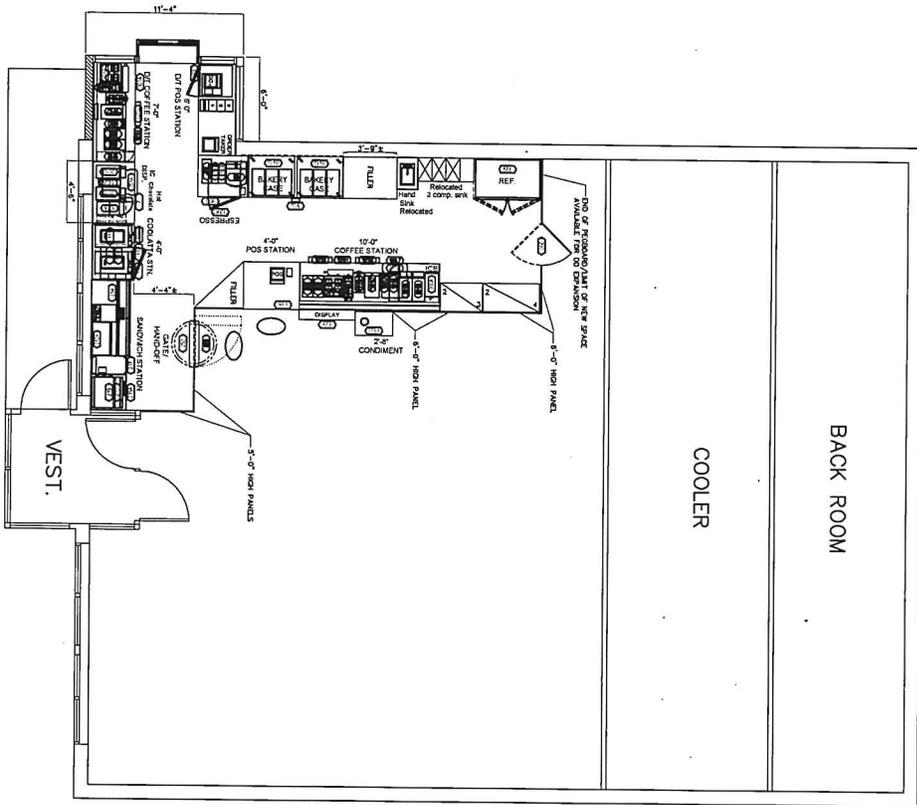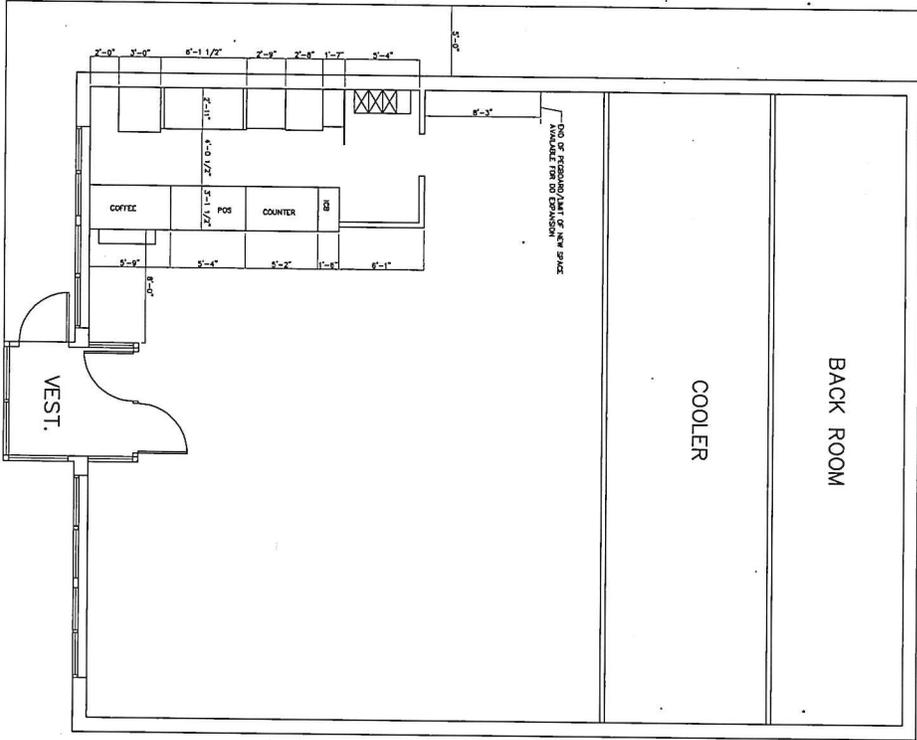

To be built pursuant to Planning Commission approval. See approved plans. SJD

SHEET
A1

JOB# D1116
DATE: 03/09/12
SCALE: 1/4" = 1'-0"
C.M. R. MARONEY

JOB LOCATION:
S. BURLINGTON, VT
1335 SHELburnE RD.
AS-BUILT FLOOR PLAN;
PROPOSED FLOOR PLAN

REVISIONS			
NO.	DESCRIPTION	BY	DATE
1	INITIAL ISSUE	JS	03/09/13



**JAMES D. SMITH,
ARCHITECT, AIA**

35 LOTHROP'S LN.
W. BARNSTABLE, MA 02668
PHONE/FAX: 508-367-8920
EMAIL: JAMESDSMITH11@COMCAST.NET

**DUNKIN'
DONUTS**

Dunkin'

[seal]ink@z